


CORE DIMENSIONS PROVIDED REFLECT FLOORS 6 THRU 10 WHERE APPLICABLE, PER AS-BUILTS.

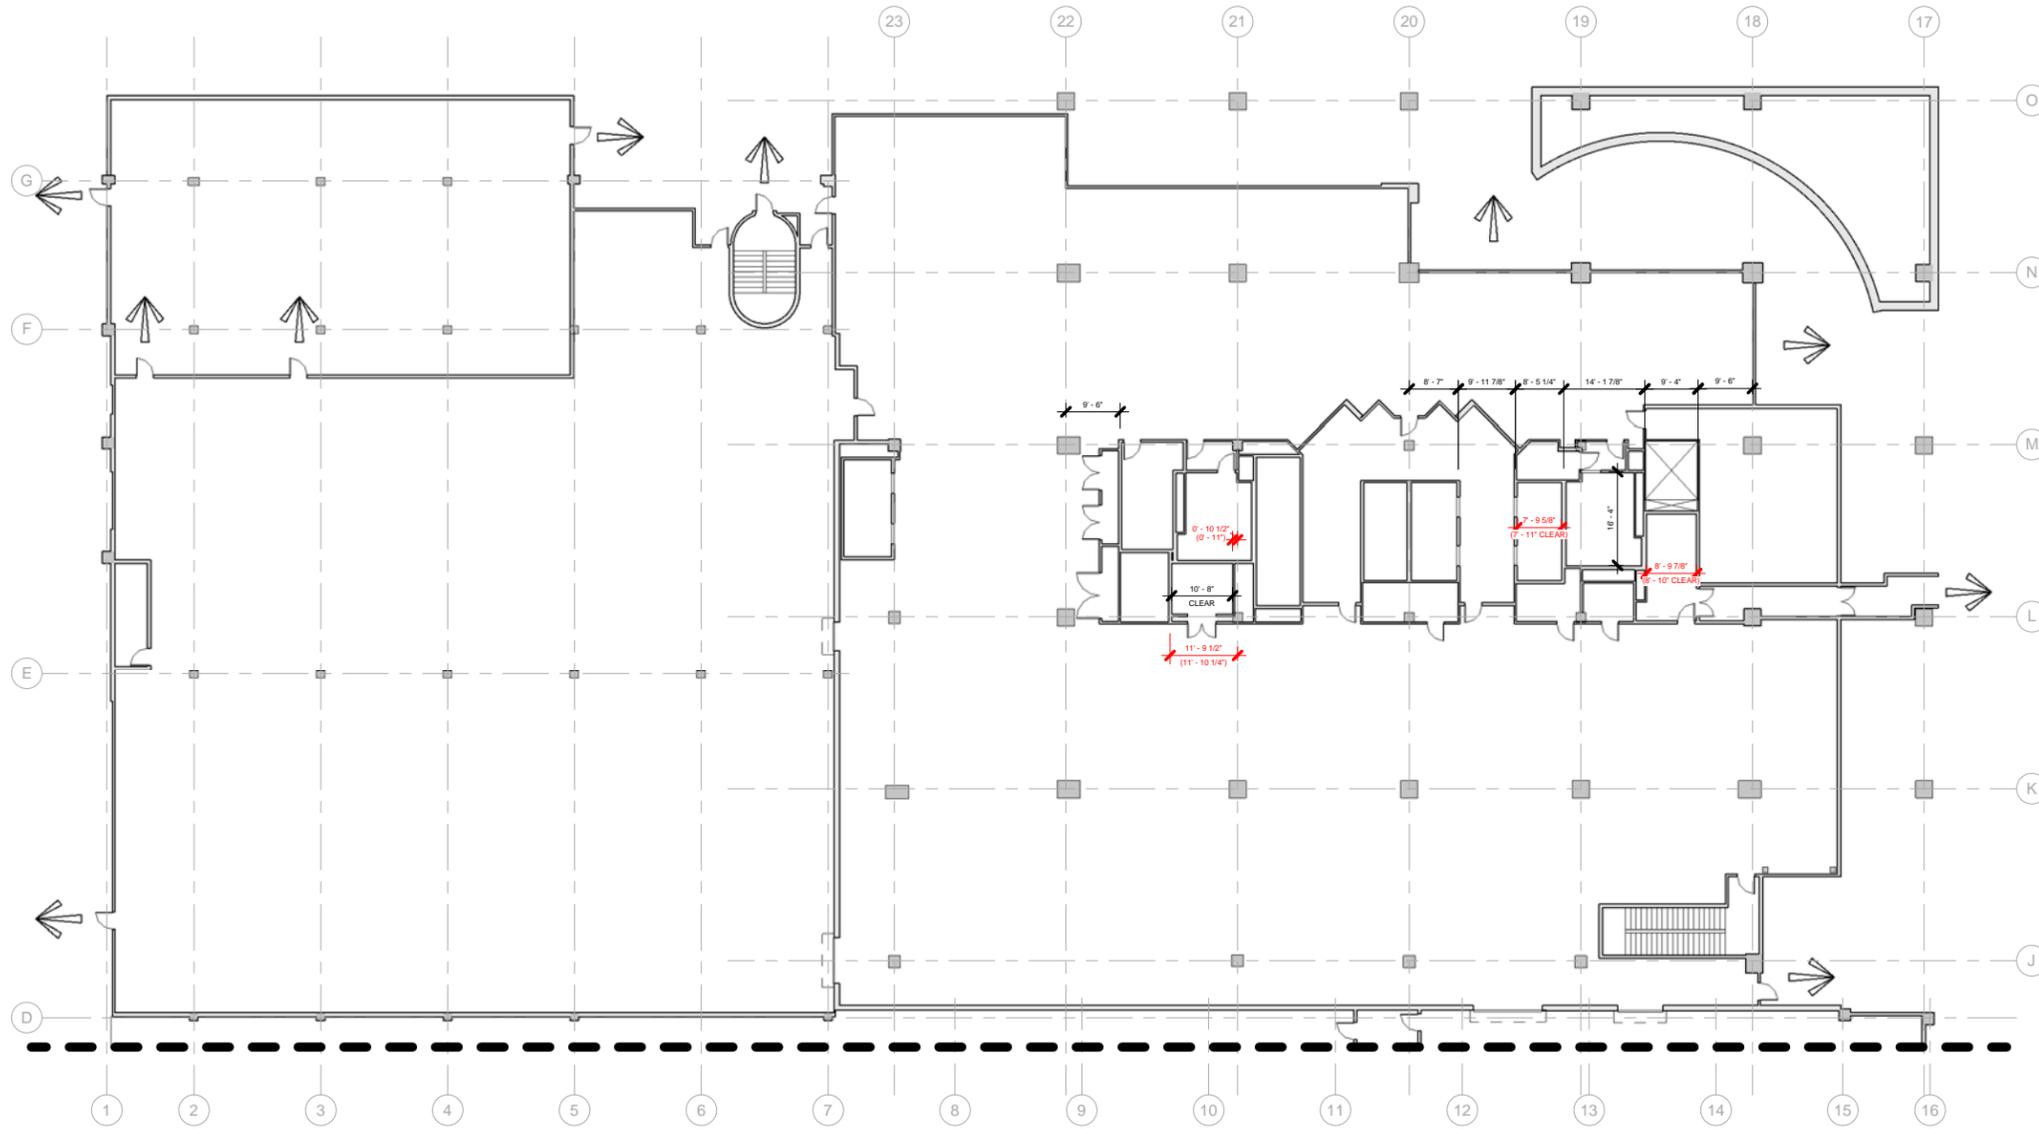

LEVEL 01 NORTH - DIMENSIONAL CONFLICTS

1/32" = 1'-0"



NOTE: CALCULATIONS BASED ON AS-BUILTS PROVIDED BY DREYFUSS & BLACKFORD ARCHITECTS, DATED 11.5.90 \*SQUARE FOOTAGE IS APPROXIMATE



**Stantec**

**Stantec Architecture**

1201 J Street, Suite 100Floor  
 Sacramento, CA 9581435  
 San Diego, CA 92101  
 Tel. 916.442.3230  
 Fax. 916.442.3249  
 www.stantec.com

Project: BOARD OF EQUILIZATION INFRASTRUCTURE STUDY

Sheet Title: 1ST LEVEL - DIMENSIONAL CONFLICTS

Project No.: 184710132

Date:

By: LKN

Drawing No.

Scale: 1/8" = 1'-0"

Issues/Rev.:

ADC.1a

CORE DIMENSIONS PROVIDED REFLECT FLOORS 6 THRU 10 WHERE APPLICABLE, PER AS-BUILTS.



1 LEVEL 01 SOUTH - DIMENSIONAL CONFLICTS  
1/32" = 1'-0"

NOTE: CALCULATIONS BASED ON AS-BUILTS PROVIDED BY DREYFUSS & BLACKFORD ARCHITECTS, DATED 11.5.90 \*SQUARE FOOTAGE IS APPROXIMATE



**Stantec Architecture**

1201 J Street, Suite 100Floor  
Sacramento, CA 9581435  
San Diego, CA 92101  
Tel. 916.442.3230  
Fax. 916.442.3249  
www.stantec.com

Project: BOARD OF EQUILIZATION INFRASTRUCTURE STUDY

Sheet Title: 1ST LEVEL - DIMENSIONAL CONFLICTS

Project No.: 184710132

Date:

By: LKN

Drawing No.

Scale: 1/8" = 1'-0"

Issues/Rev.:

ADC.1b



2ND FLOOR SHELL DIMENSIONS NOT PROVIDED IN AS-BUILTS. 3RD FLOOR SHELL DIMENSIONS WERE USED WHERE APPLICABLE.

NOTE: CORE DIMENSIONS PROVIDED REFLECT FLOORS 6 THRU 10, PER AS-BUILTS.

1 LEVEL 02 - DIMENSIONAL CONFLICTS  
1/32" = 1'-0"



NOTE: CALCULATIONS BASED ON AS-BUILTS PROVIDED BY DREYFUSS & BLACKFORD ARCHITECTS, DATED 11.5.90 \*SQUARE FOOTAGE IS APPROXIMATE



**Stantec Architecture**

1201 J Street, Suite 100Floor  
Sacramento, CA 9581435  
San Diego, CA 92101  
Tel. 916.442.3230  
Fax. 916.442.3249  
www.stantec.com

Project: BOARD OF EQUILIZATION INFRASTRUCTURE STUDY

Sheet Title: 2ND LEVEL - DIMENSIONAL CONFLICTS

Project No.: 184710132


Date:

By: LKN

Drawing No.

Scale: 1/8" = 1'-0"

Issues/Rev.:

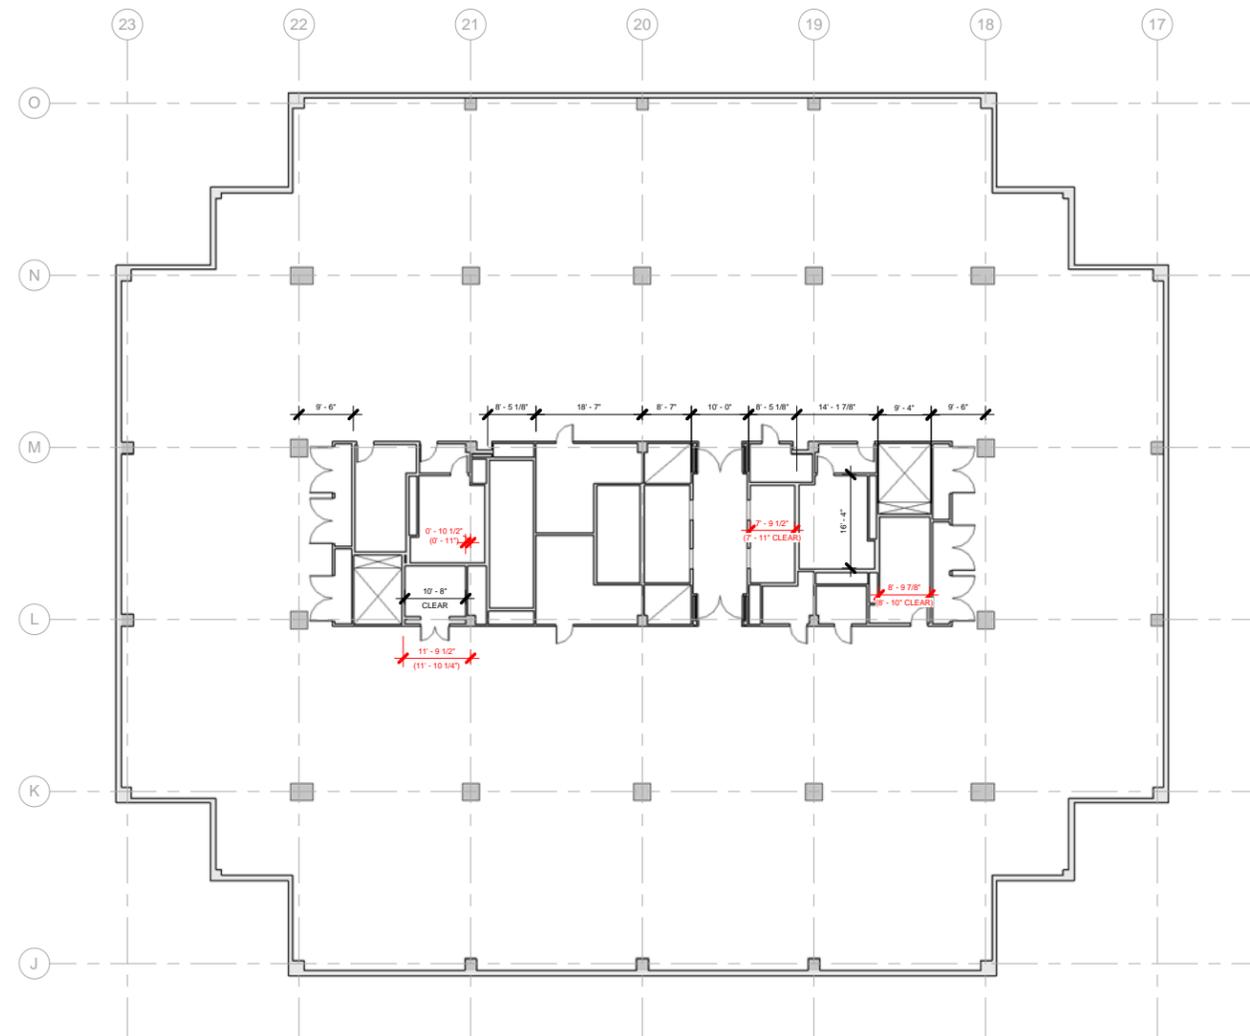

NOTE: CORE DIMENSIONS PROVIDED REFLECT FLOORS 6 THRU 10, PER AS-BUILTS.

1 LEVEL 03 - DIMENSIONAL CONFLICTS  
1/32" = 1'-0"



NOTE: CALCULATIONS BASED ON AS-BUILTS PROVIDED BY DREYFUSS & BLACKFORD ARCHITECTS, DATED 11.5.90 \*SQUARE FOOTAGE IS APPROXIMATE



**Stantec Architecture**

1201 J Street, Suite 100Floor  
Sacramento, CA 9581435  
San Diego, CA 92101  
Tel. 916.442.3230  
Fax. 916.442.3249  
www.stantec.com

Project: BOARD OF EQUILIZATION INFRASTRUCTURE STUDY

Sheet Title: 3RD LEVEL - DIMENSIONAL CONFLICTS

Project No.: 184710132

Date:

By: LKN

Drawing No.

Scale: 1/8" = 1'-0"

Issues/Rev.:

ADC.3